

- LEGEND:**
- CURRENT STAGE BOUNDARY
 - - - 150mm WASTEWATER MAIN
 - - - - - 100mm SEWER LATERAL
 - 10500 SEWER MANHOLE

- NOTES:**
1. ALL 1000 SS LATERALS HAVE BEEN LAID @ 1:80 MIN GRADE UNLESS STATED OTHERWISE.
 2. SEE PLAN FACE FOR SEWER MAIN, RISING MAIN AND LATERAL OFFSETS TO LEGAL BOUNDARIES.
 3. ALL INVERTS SHOWN ARE DOWNSTREAM INVERTS.

ORIGIN OF LEVELS:	CC 370 NO 2 (EJ8V)
REDUCED LEVEL:	58.154m
D@UM:	MEAN SEA LEVEL (LVD 1937)
THE SITE D@UM IS:	MIN 19 DP 535315
REDUCED LEVEL:	38.108m

REV	D@E	REVISION DETAILS	ISSUED
A	09/12/20	FOR INFORMATION	CWH


PROJECT

CLIENT

SURVUS
CONSULTANTS
PLANNING • SURVEYING • ENGINEERING

4 Meadow Street, PO Box 5558, Papanui, Christchurch
 P 03 352 5599 AMBERLEY 03 314 9200
 F 03 352 5527 ASHBURTON 03 307 7021
 TOLL FREE 0508 787 887 DARFIELD 03 318 8151

DRAWING TITLE		
SEWER RETICULATION AS BUILT SHEET 1 OF 2 STAGE 8-9		
STATUS	SCALE	SIZE
FOR INFORMATION	1:500	A1
PROJECT NO	DRAWING NO	REVISION
14417	S8-AB-01	A

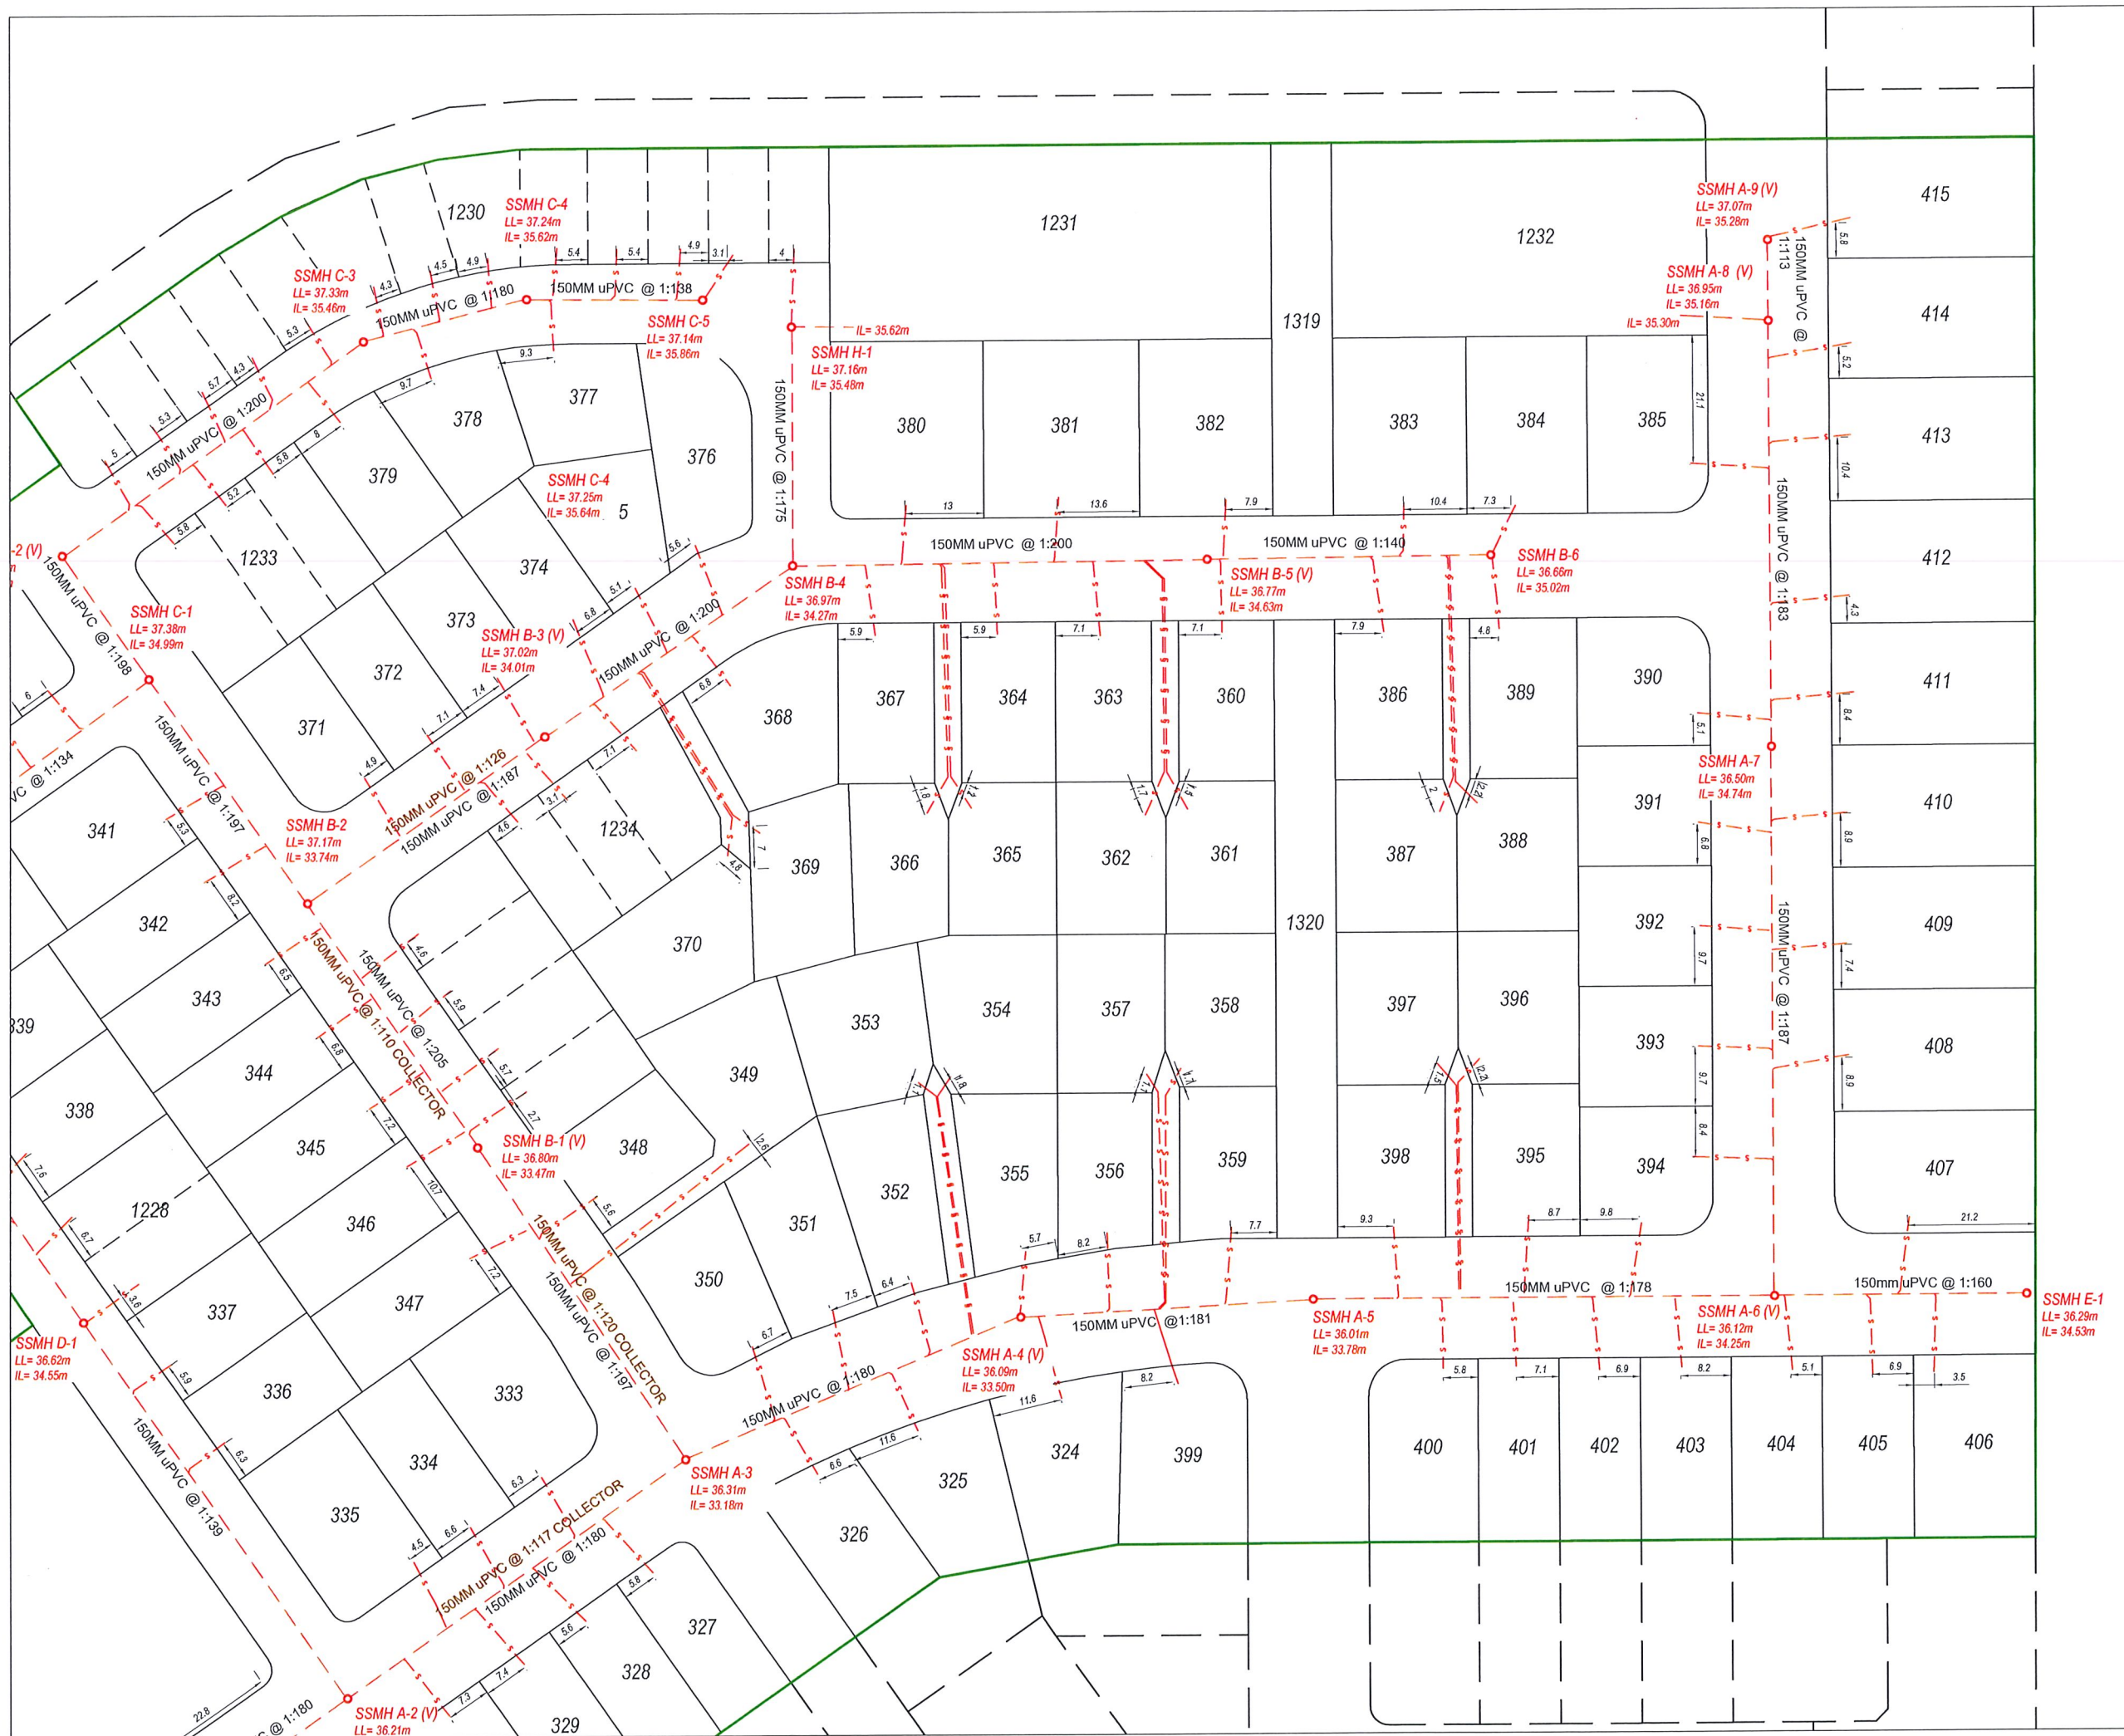

LEGEND:

- CURRENT STAGE BOUNDARY
- - - 150mm WASTEWATER MAIN
- S - S - 100mm SEWER LATERAL
- 1000Ø SEWER MANHOLE

NOTES:

1. ALL 100Ø SS LATERALS HAVE BEEN LAID @ 1:80 MIN GRADE UNLESS STATED OTHERWISE.
2. SEE PLAN FACE FOR SEWER MAIN, RISING MAIN AND LATERAL OFFSETS TO LEGAL BOUNDARIES.
3. ALL INVERTS SHOWN ARE DOWNSTREAM INVERTS.

ORIGIN OF LEVELS:	CC 370 NO 2 (E:88V)
REDUCED LEVEL:	58.154m
D@UM:	MEAN SEA LEVEL (LVD 1937)
THE SITE D@UM IS:	MN 19 DP 535315
REDUCED LEVEL:	38.108m

REV	D@E	REVISION DETAILS	ISSUED
A	09/12/20	FOR INFORMATION	CVH

PROJECT



CLIENT



SURVUS CONSULTANTS
 PLANNING + SURVEYING + ENGINEERING

4 Meadow Street, PO Box 5558, Papanui, Christchurch
 P 03 352 5599 AMBERLEY 03 314 9200
 F 03 352 5527 ASHBURTON 03 307 7021
 TOLL FREE 0508 787 887 DUNEDIN 03 318 8151

DRAWING TITLE		
SEWER RETICULATION AS BUILT SHEET 2 OF 2 STAGE 8-9		
STATUS	SCALE	SIZE
FOR INFORMATION	1:500	A1
PROJECT NO	DRAWING NO	REVISION
14417	S8-AB-02	A